

STATE OF OKLAHOMA  
DEPARTMENT OF HIGHWAYS  
PLANS AND SURVEY DEPARTMENT

FLOOD INFORMATION FORM

To be used in obtaining and transmitting flood water elevations for Plans & Survey office record files. This information to be obtained by all Chiefs of Party in their vicinity in times of unusual high water, or at any time available from a reliable source. The elevations can be recorded by level reading, by measurement from bridge floor, in relation to a house, above roadbed or any other dependable, clear manner that fits the situation, the highest order possible to be used. Separate report to be made on each crossing or place obtained.

County Caddo Date highwater occurred June 23, 1948

Highway number US 66 Name of stream Branch of Deer Creek

Direction and distance from nearest town, village or store 2 miles east of the

Hydro junction

Section, Township and Range Between Section 2&11 - T12N - R13W

Description of Location 70' steel truss Sta. 1275+02.21 as built Plans FAP-204

Method obtained Wye level

Elevation 1390.2 Source of levels From as built FAP-204 Plans

Was highwater mark obtained from actual water, drift, local resident, U. S. Engineers, etc? From very distinct marks on house 150 south & 200 west of

bridge and confirmed by people who live in house


Explanatory Remarks This H.W. was obtained by Stout and Stephens and was caused

from 8" to 19" rain.

Location to be shown on back of this sheet as a check.

Field Note: To be sent to Engr.  
of Plans & Survey (1 copy).

Office Note: To be filed in Flood  
Information by Counties.

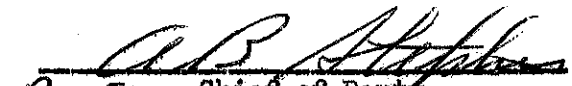  
R. B. Stephens Chief of Party

June 24, 1948

Date


E L A I N E C O U N T Y

24

25

26

SOUTH CANAL

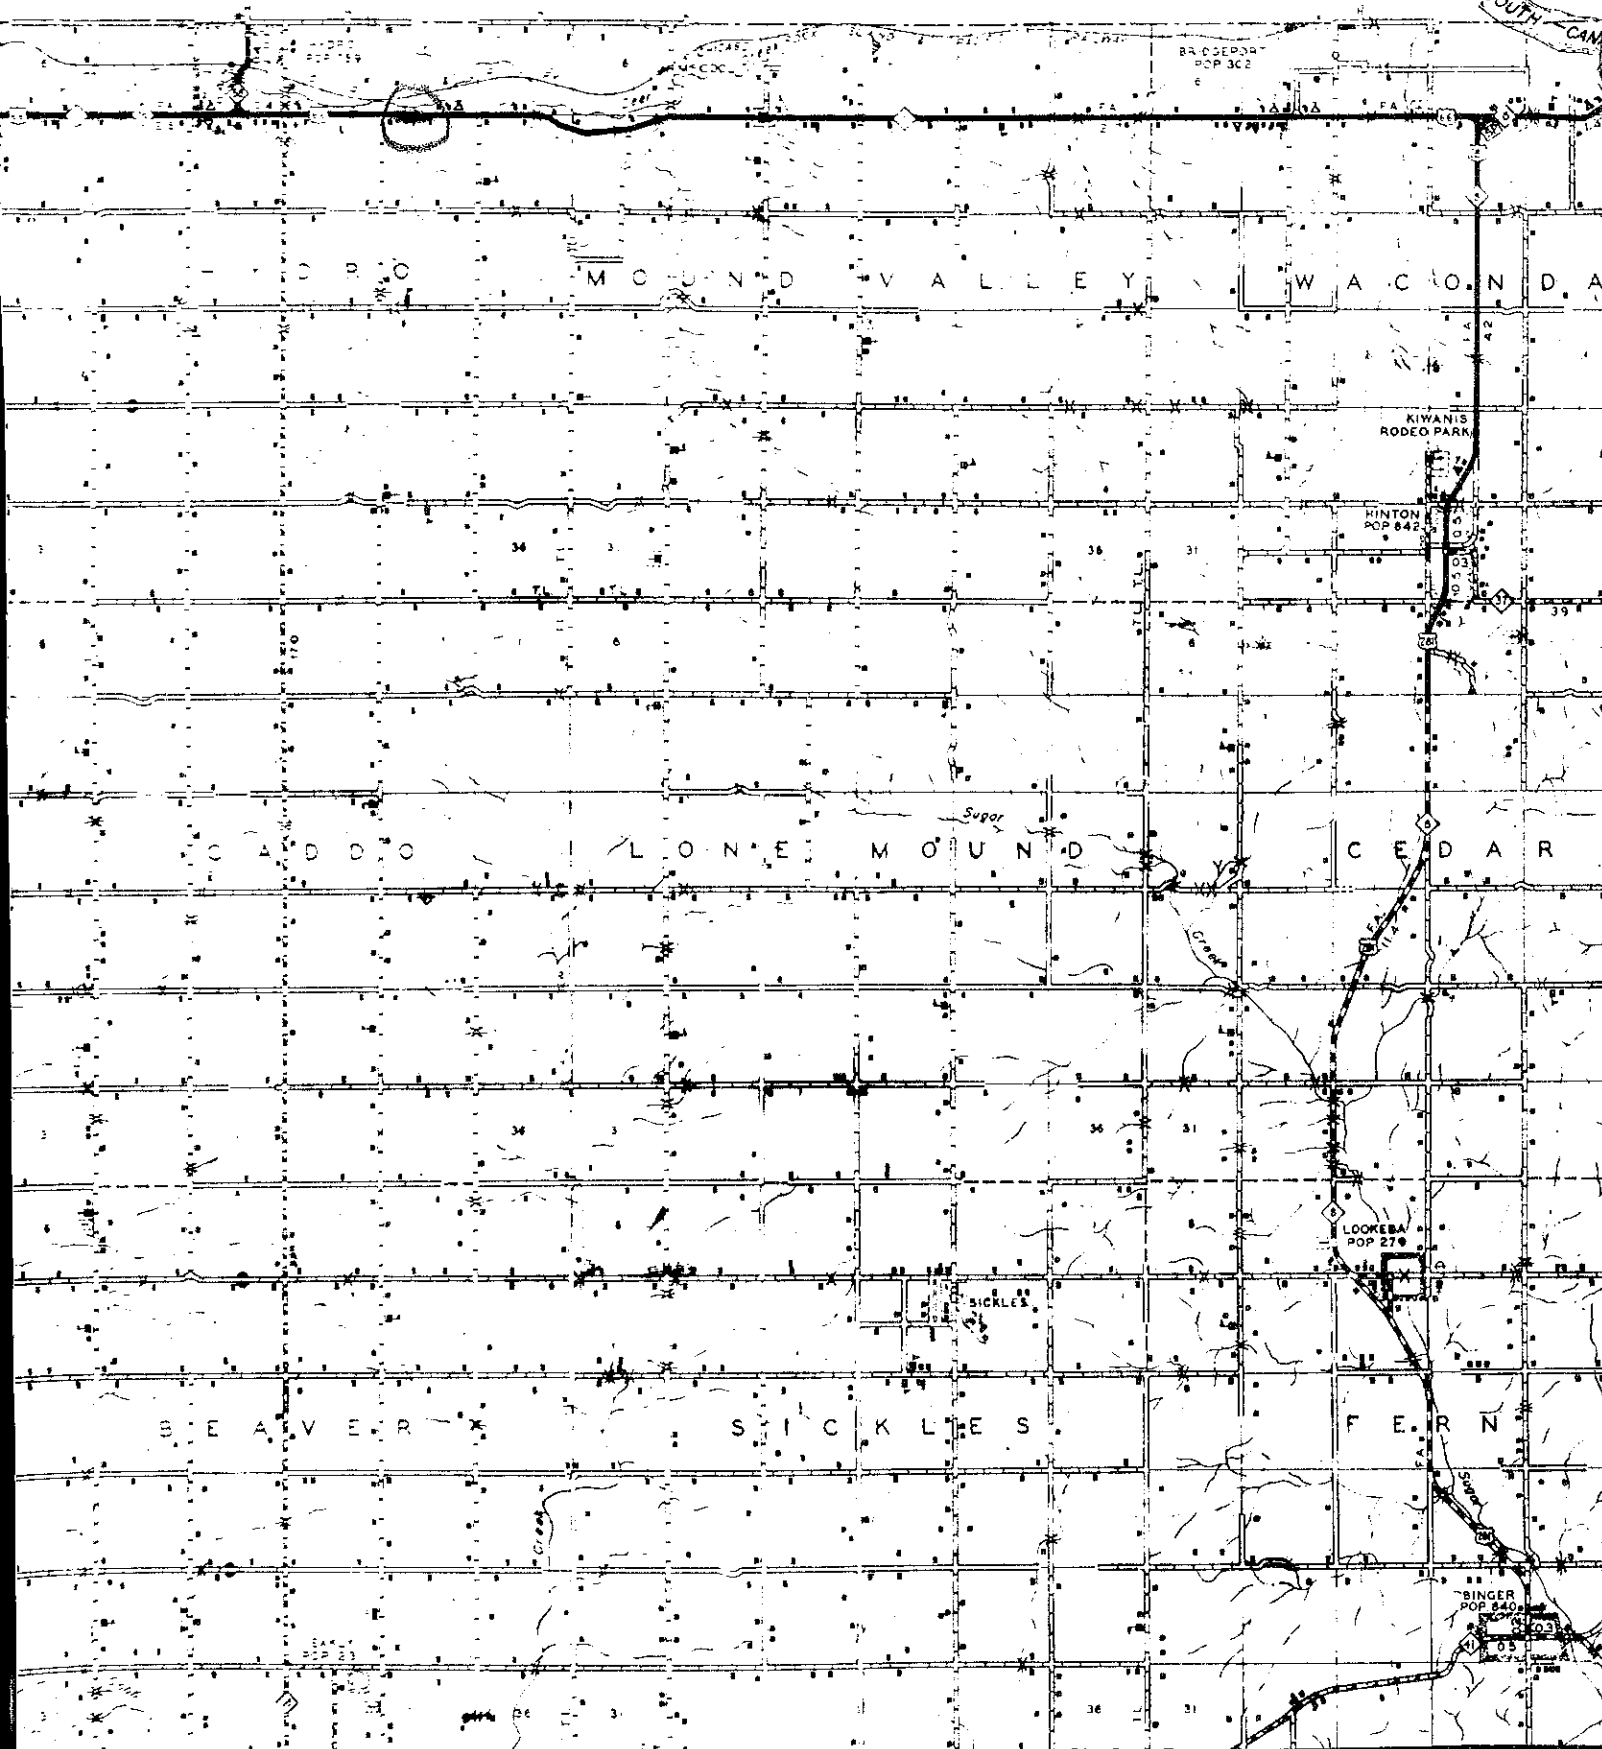

BRIDGEPORT  
POP 302

CUMMINGS VALLEY

WAGONDA

KIWANIS RODEO PARK

HINTON  
POP 842

CADDO

LONE MOUND

CEDAR

BEAVER

SICKLES

FERN

LOOREBA  
POP 279

BINGER  
POP 840

Sugar

Creek

Sumner

34

31

36

31

03

05

39

36

31

36

31

36

34

31

36

31

34

31

36

31

34

31

36

31