


STATE OF OKLAHOMA  
DEPARTMENT OF HIGHWAYS  
SURVEY DIVISION

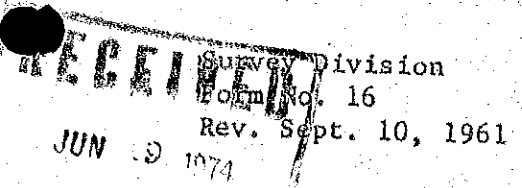

FLOOD INFORMATION FORM

To be used in obtaining and transmitting flood water elevations for Survey Division office record files. This information to be obtained by all Chiefs of Party or others in their vicinity in times of unusual high water, or at any time available from a reliable source. The elevations can be recorded by level reading, by measurement from bridge floor, in relation to a house, above roadbed or any other dependable, clear manner that fits the situation, the highest order possible to be used. Separate report to be made on each crossing or place obtained.

County Creek Date highwater occurred June 9, 1974

Highway number SH 117 Name of stream Pole Cat Creek

Direction and distance from nearest town, village or store Approximately two miles east of Sapulpa.

Section, Township and Range Between Sec. 6, T-17-N, R-12-E and Sec. 31, T-18-N, R-12-E.

Description of Location At approx. Sta. 108 on FAP US-S917(2)S, 1959 as built plans. at west end present bridge.

Elevation 658.2 Feet Source of levels Mean Sea Level "USC&GS" taken from FAP US-S917(2)S Plans

Method obtained Measured down from Headwall Date obtained June 13, 1974

Did it appear to be  normal  medium  extreme  do not know

Was highwater mark obtained from actual water, drift, local resident, U. S. Engineers, etc.? Silt and drift after water receded. Obtained by Moran & Barnes.

Explanatory Remarks Elevation of Headwall, west end of bridge, as taken from plans is 667.40 feet. Highwater elevation is 9.2 Ft. below Headwall. Highwater caused from heavy thunder storms and tornadic weather the evening and night of June 8, 1974. The weather bureau estimated between 6 & 10 inches of rain fell throughout the area.


Location to be shown on back of this sheet as a check.

Field Note: To be sent to  
Survey Engineer

Russ D. Moran  
Location Engineer

June 17, 1974  
Date

LOCATION NUMBER 13

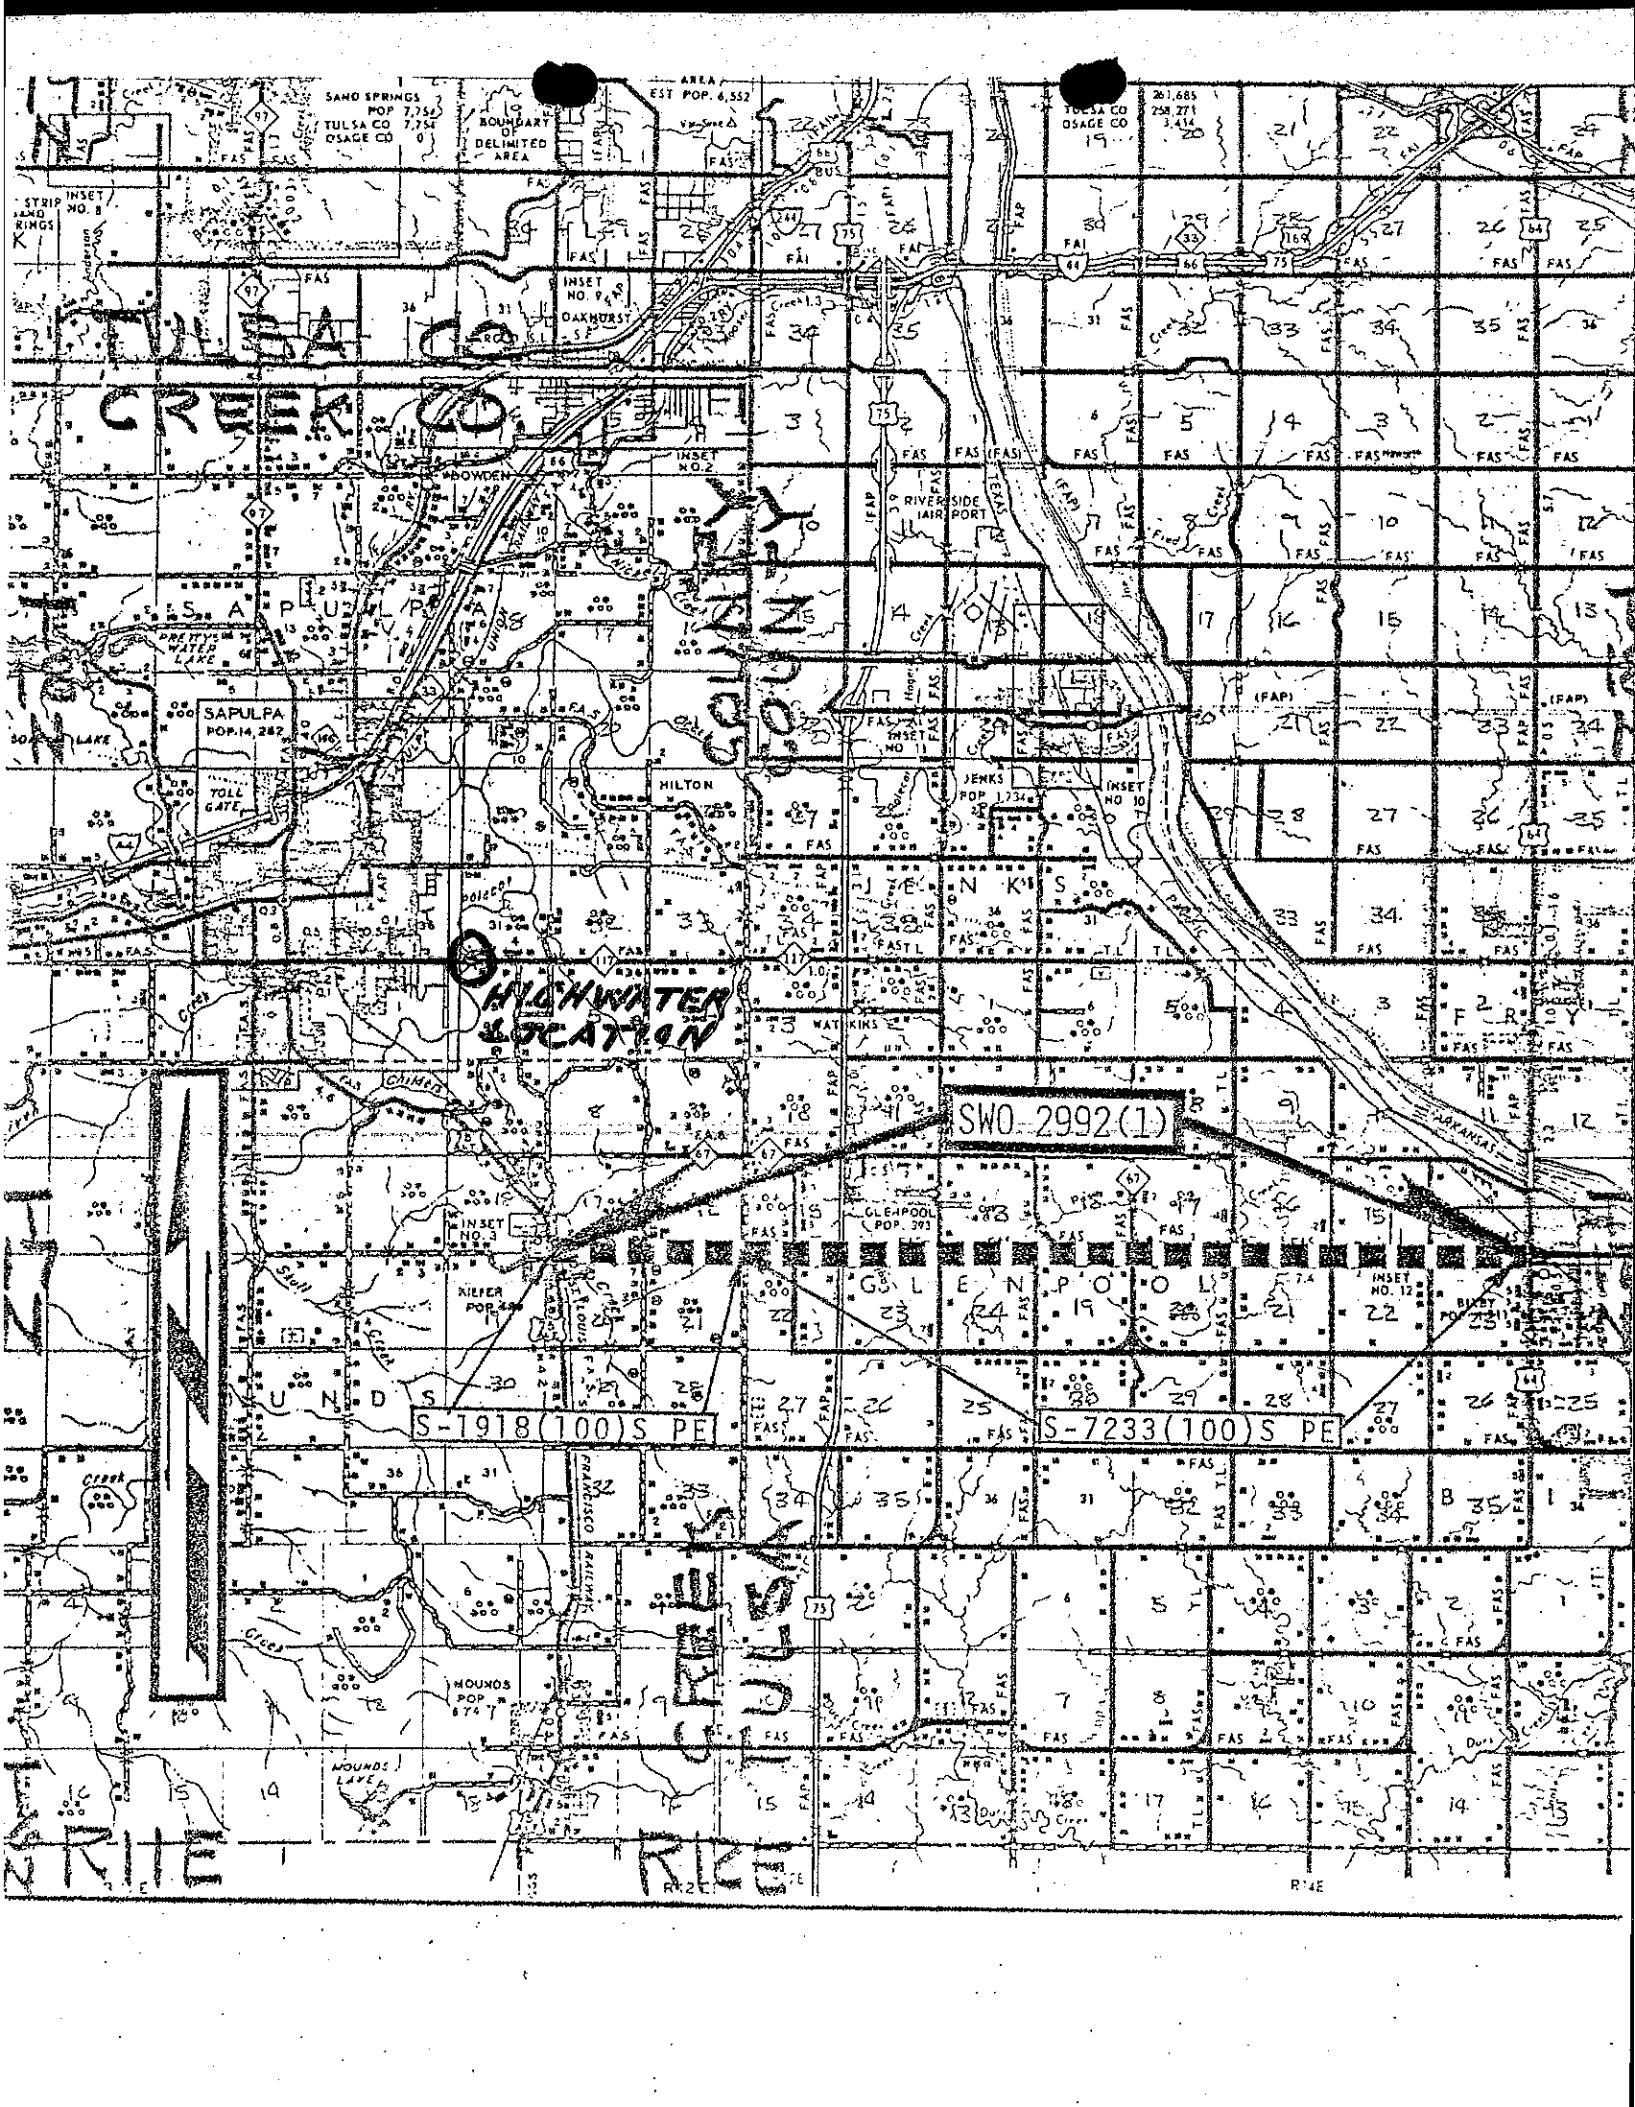

SAND SPRINGS  
POP 7,752  
TULSA CO  
OSAGE CO

AREA  
EST POP. 4,552

261,685  
258,271  
3,414  
TULSA CO  
OSAGE CO

HIGHWATER  
LOCATION

SWO-2992(1)

S-1918(100)S PE

S-7233(100)S PE

TULSA  
CREEK

RICE

TULSA  
CREEK

SAPULPA

SAPULPA  
POP. 14,282

HILTON

JENKS  
POP. 1,234

N. KINGS

WATKINS

GLENNPOOL  
POP. 373

GLEN POOL

UNION

UNION

WHEEL

R74E