

RECEIVED

Survey Division  
Form No. 16

JUN 19 1974 Rev. Sept. 10, 1961

STATE OF OKLAHOMA  
DEPARTMENT OF HIGHWAYS  
SURVEY DIVISION

FLOOD INFORMATION FORM

To be used in obtaining and transmitting flood water elevations for Survey Division office record files. This information to be obtained by all Chiefs of Party or others in their vicinity in times of unusual high water, or at any time available from a reliable source. The elevations can be recorded by level reading, by measurement from bridge floor, in relation to a house, above roadbed or any other dependable, clear manner that fits the situation, the highest order possible to be used. Separate report to be made on each crossing or place obtained.

County Tulsa Date highwater occurred June 9, 1974

Highway number US 75 Name of stream Nichol Creek

Direction and distance from nearest town, village or store Approximately 2 miles west and 1/4 mile north of Jenks. Just south of 91st St. South.

Section, Township and Range Between Sec's 22 & 23, T-18-N, R-12-E.

Description of Location At approx. Sta. 250+25 on FAP F-726 (2) US 75 as built plans. At south end of present concrete bridge.

Elevation 628.6 Ft. Source of levels Mean Sea Level "USC&GS" taken from FAP F-726 (2) as built plans.

Method obtained Measured down from bridge. Date obtained June 13, 1974

Did it appear to be  normal  medium  extreme  do not know

Was highwater mark obtained from actual water, drift, local resident, U. S. Engineers, etc.? Silt and drift after water receded. Obtained by Moran & Barnes.

Explanatory Remarks Elevation of south end bridge, centerline RDY as taken from plans is 634.00 Ft. High water elevation is 5.4 Ft. below bridge RDY.

Highwater due to heavy thunder storms and tornadic weather the evening and night of June 8, 1974. The Weather Bureau estimated between 6 & 10 inches of rain fell in the Tulsa area.


Location to be shown on back of this sheet as a check.

Field Note: To be sent to  
Survey Engineer

Russ D. Moran  
Location Engineer

June 17, 1974  
Date

Location 6" a"

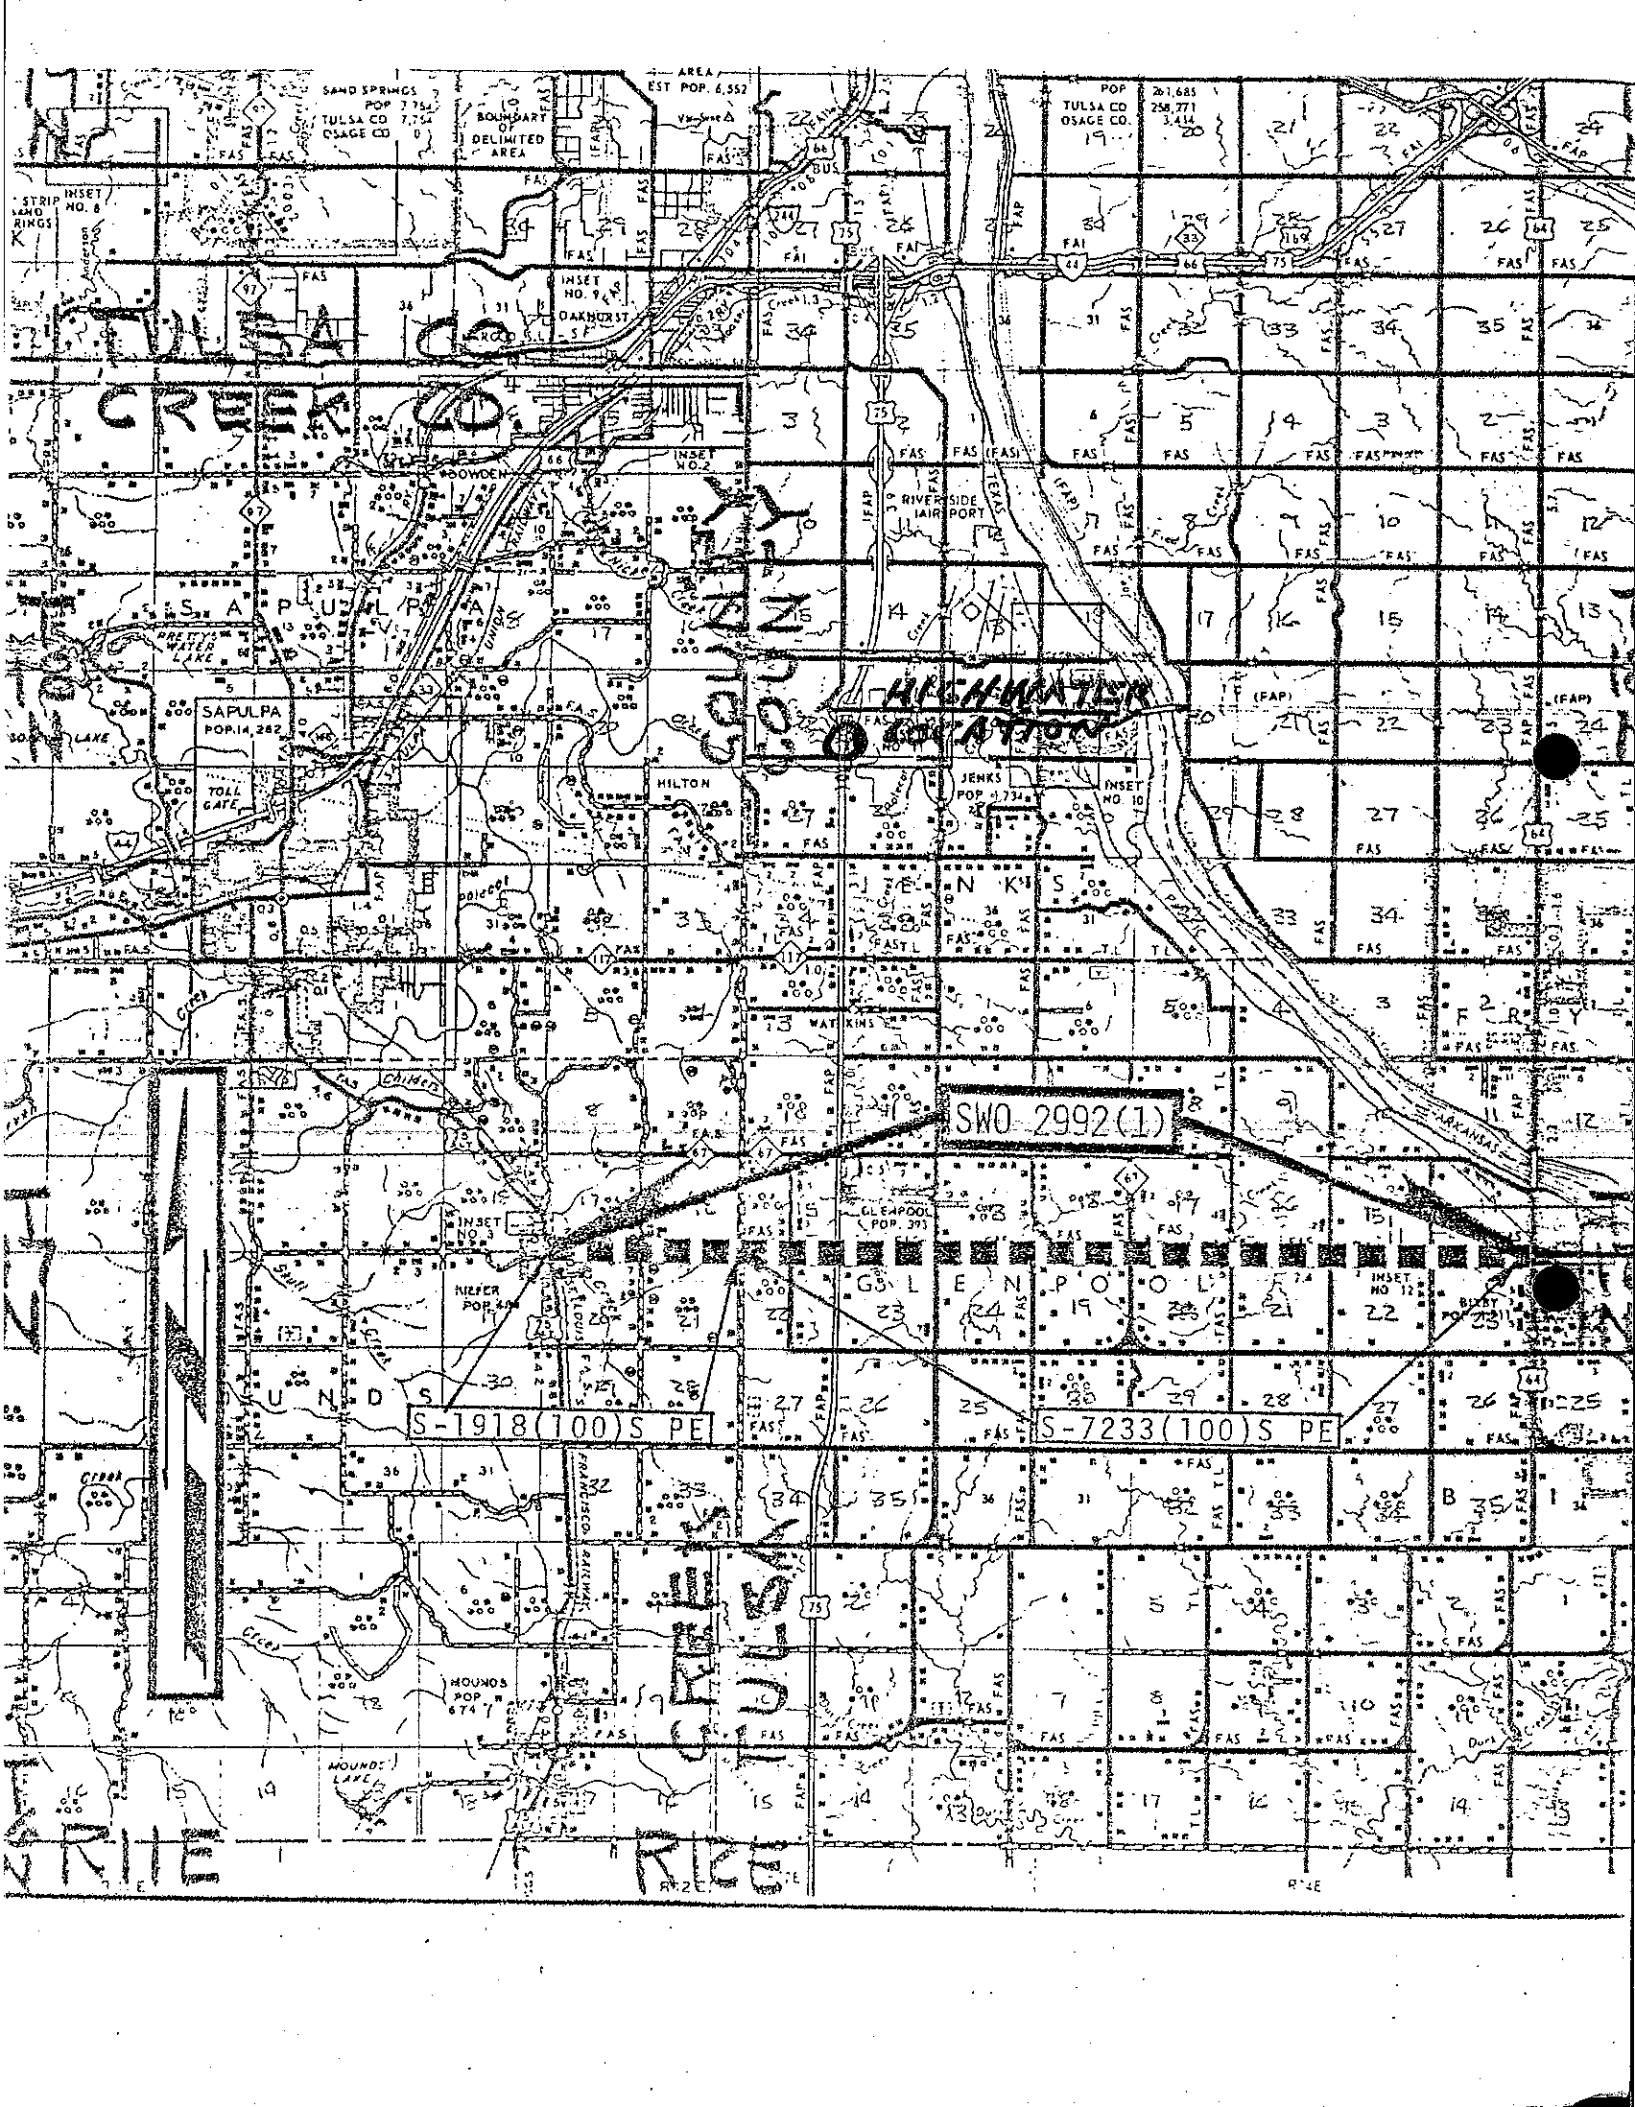

SAND SPRINGS  
POP 775  
TULSA CO  
OSAGE CO

AREA  
EST POP. 6,552

POP 201,685  
TULSA CO  
OSAGE CO  
19...

INSET  
NO. 8  
STRIP  
LAND  
RINGS

BOUNDARY  
OF  
DELIMITED  
AREA

INSET  
NO. 9  
DANKURST

TULSA  
CREEK  
CO

S. A. P. U. L. P. A.

SAPULPA  
POP. 14,262  
TOLL  
GATE

HILTON

HIGHWATER  
STATION

JENKS  
POP. 4,734

N. K. S.

WATKINS

SWO 2992(1)

S-1918(100)S PE

S-7233(100)S PE

UNDS

GLEN POOL

WHITE

RICE