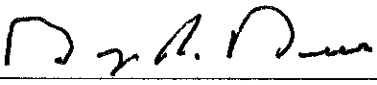


**OKLAHOMA DEPARTMENT OF TRANSPORTATION
SURVEY DIVISION**

FLOOD INFORMATION FORM


Division #:	1 <input type="checkbox"/> 2 <input type="checkbox"/> 3 <input type="checkbox"/> 4 <input type="checkbox"/> 5 <input checked="" type="checkbox"/> 6 <input type="checkbox"/> 7 <input type="checkbox"/> 8 <input type="checkbox"/>
County:	Tillman
Date Highwater occurred:	06/29/07
Highway Number:	S.H. 5
Name of Stream:	Tributary to Jack Creek
Direction and distance from nearest town, or highway junction	Location is 6.3 miles east of Jct. S.H. 54 North of Hollister or 4.7 miles west of Jct. S.H. 36 south of Chattanooga or 0.3 miles east of NS236 Section Line.
Section, Township, Range:	Between Sections 10 & 15, T-2-S, R-15-W, I.M.
Description of Location:	RCB cross-drain
Highwater Elevation:	1107.3 (Asphalt = 1107.0)
Level Datum & Source:	NRH-207-B As Built Plans
Method used:	Differential Leveling
Date Elevation Obtained:	07/05/07
Apparent Magnitude:	Normal <input type="checkbox"/> Medium <input type="checkbox"/> Extreme <input checked="" type="checkbox"/> Don't Know <input type="checkbox"/>
Was Highwater Mark obtained from actual water, drift, local resident, or other source?	High-Water was obtained from drift at this location.
Explanatory Remarks:	High-Water was 0.3 feet above asphalt paving.

Note: Show Vicinity Map on back of form

Name (signature) 
 Name (Printed) Danny R. Dees, PLS
 Date: 07/09/07

Survey Division
 Form No. 16
 Revised: 5/09/2007

LOCATION No 18

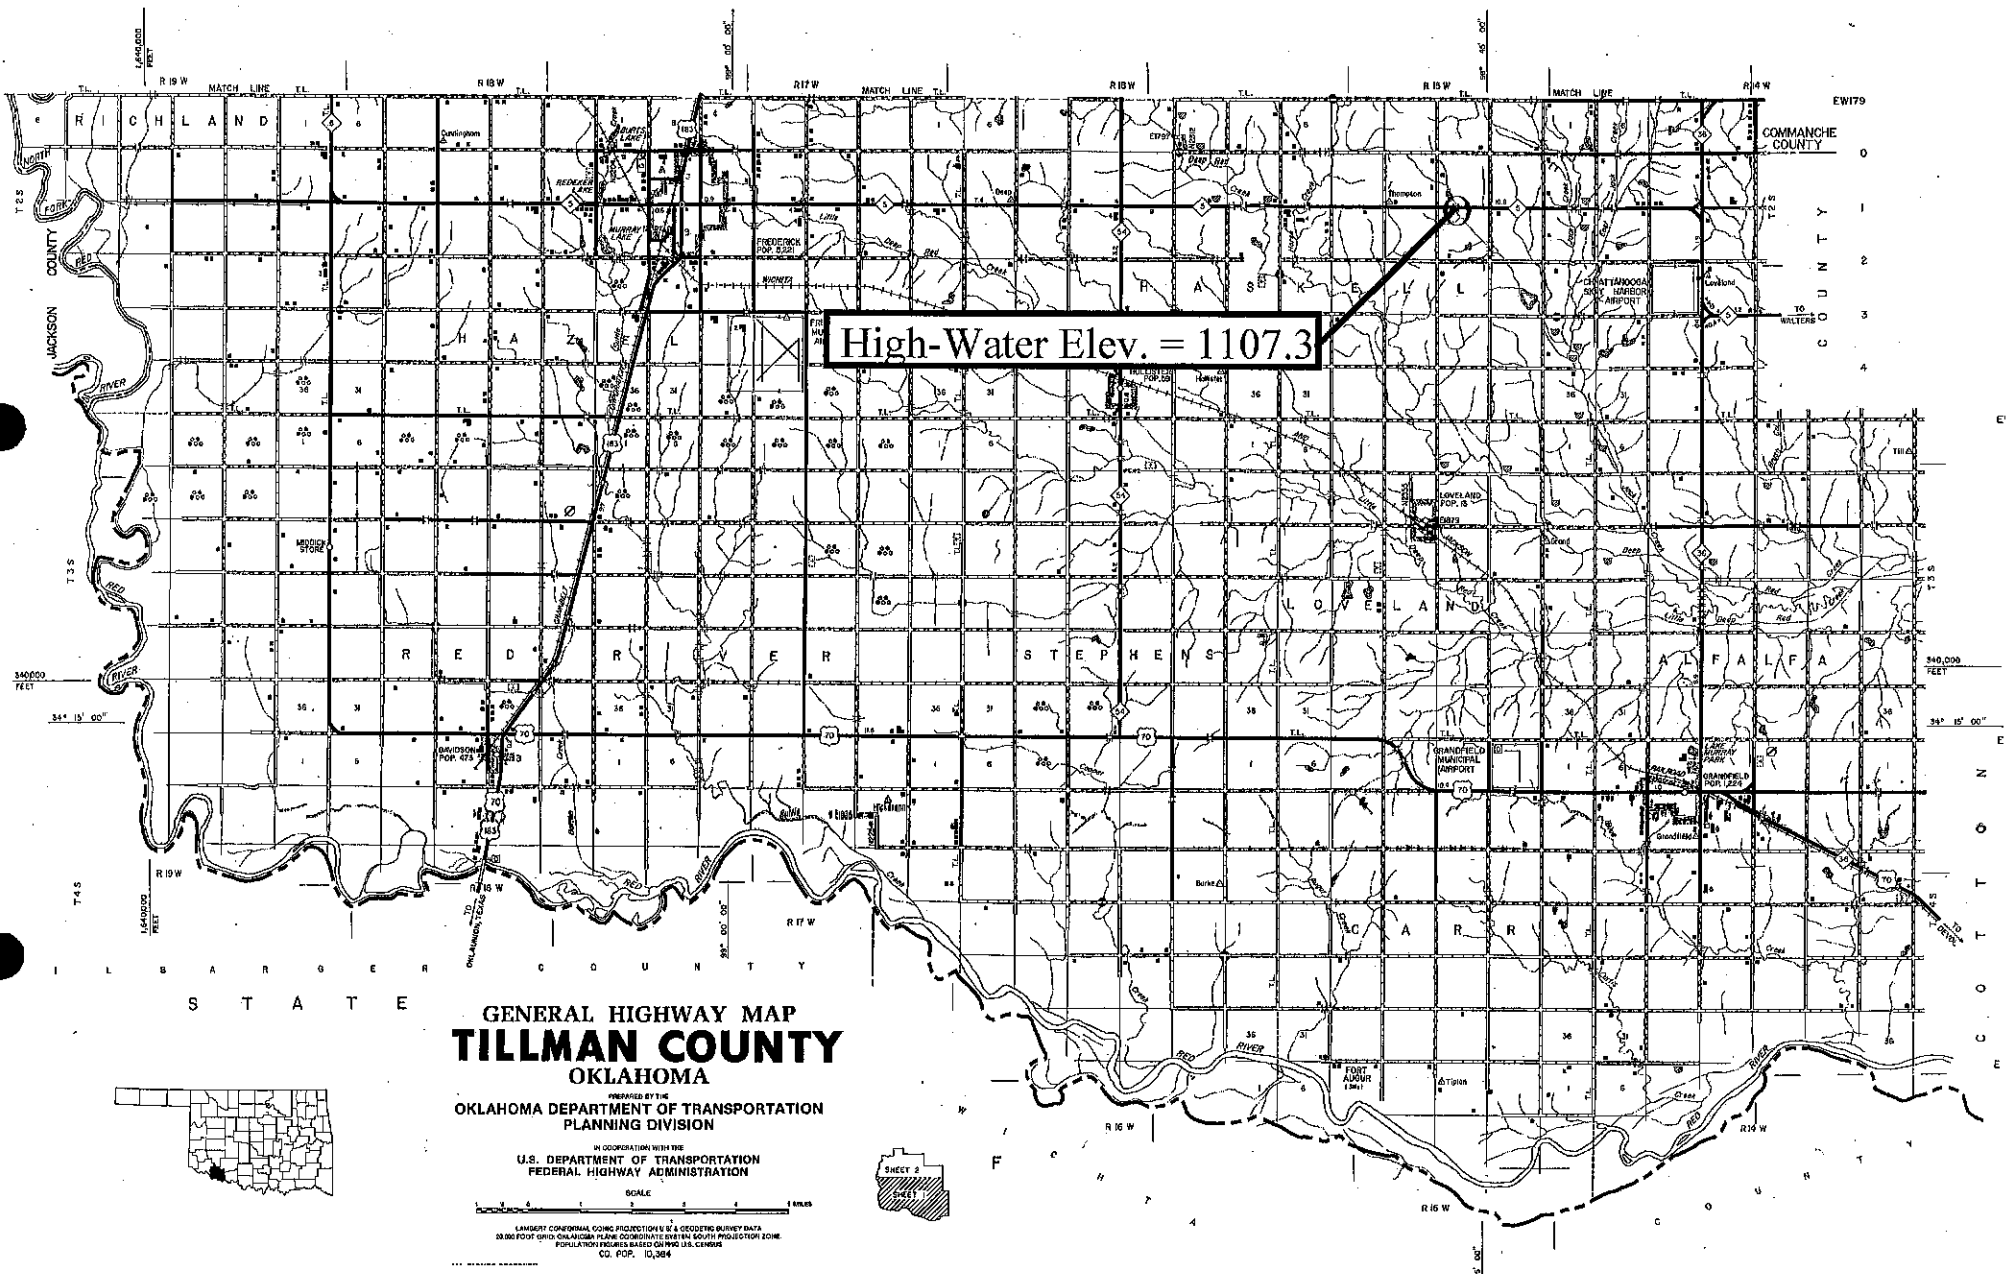

High-Water Elev. = 1107.3

**GENERAL HIGHWAY MAP
TILLMAN COUNTY
OKLAHOMA**

OKLAHOMA DEPARTMENT OF TRANSPORTATION
PLANNING DIVISION

IN COOPERATION WITH THE
U.S. DEPARTMENT OF TRANSPORTATION
FEDERAL HIGHWAY ADMINISTRATION

SCALE: 1" = 1 MILE

LARGEST CONFORMAL GOING PROJECTION BY A GEODETIC SURVEY DATA
2000 FOOT GRID ON CHANGING PLANE COORDINATE SYSTEM SOUTH PROJECTION ZONE
POPULATION FIGURES BASED ON 1990 U.S. CENSUS
CD. POP. 10,364

